LONG SEAMS

COURSE	ORIENTATION	ORIENTATION
1	135°	315°
2	139.5°	319.5°
3	135°	315°
4	139.5°	319.5°
5	135°	315°
6	139.5°	319.5°
7	135°	315°
8	139.5°	319.5°
9	135°	315°
10	139.5°	319.5°
11	135°	315°

*VERT – TOP TO BOTTOM

Ship loose items:

(2 PCs) Handrails w/ Hardware
(1 PC) Crossover w/ Hardware
(2 PCs) Crossover Handrails w/ Hardware

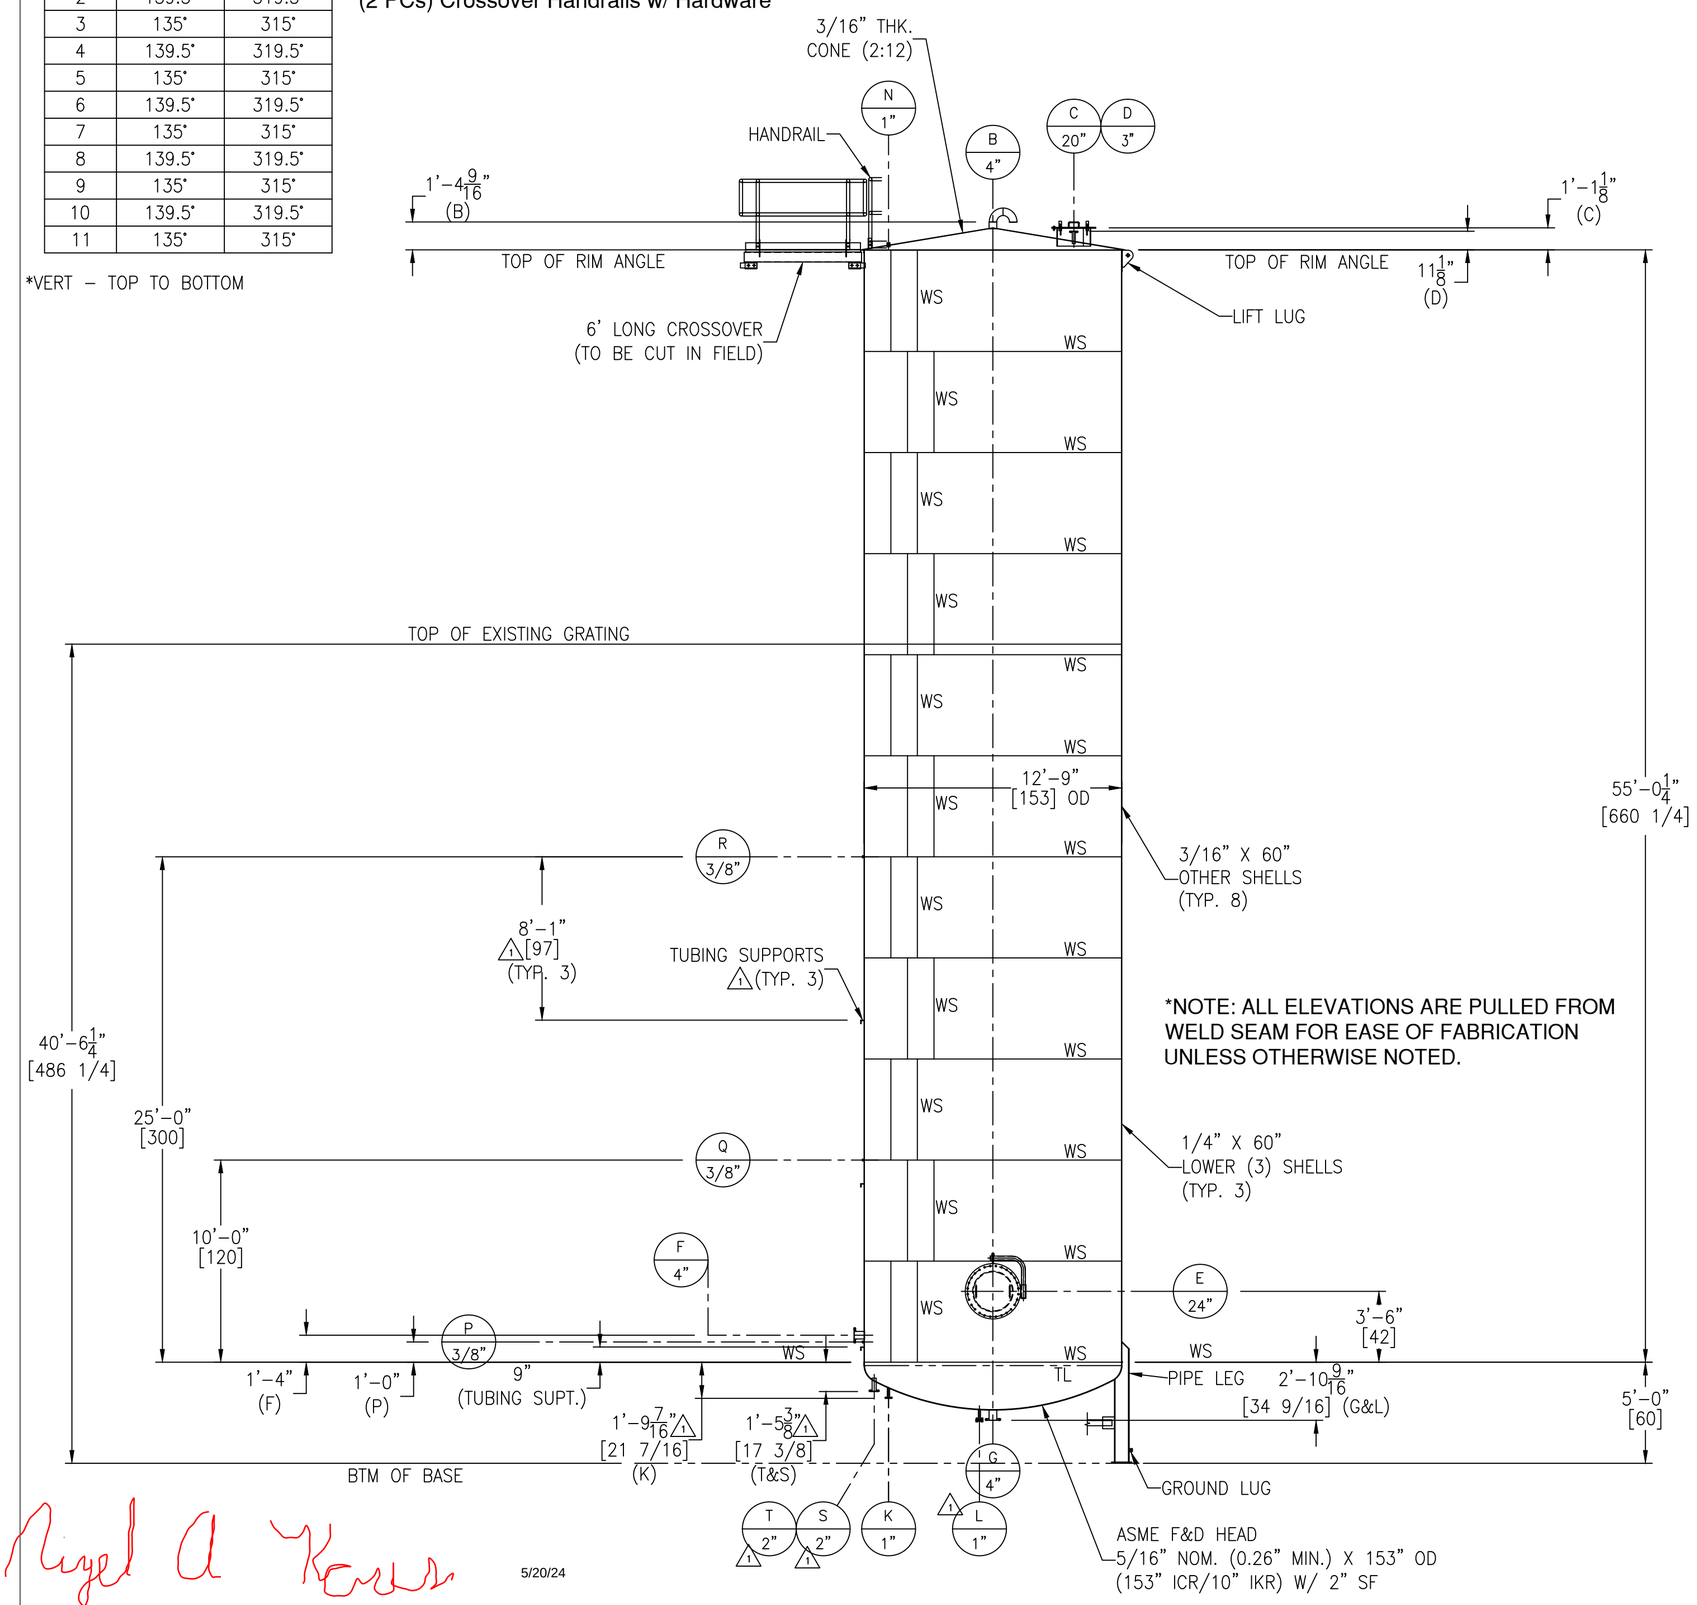

Nigel A Kowas 5/20/24

GENERAL NOTES

1.) COVER ALL FLANGES, OPENINGS & MACHINED SURFACES PRIOR TO SHIPMENT UNLESS OTHERWISE NOTED.
2.) BOLT HOLES TO STRADDLE 0° & 180° UNLESS OTHERWISE NOTED.
3.) REPADS TO HAVE (1) ø1/4" NPT TELL-TALE HOLES FOR PNEUMATIC TESTING AT 2 PSIG FOR PRESSURE RETAINING PARTS. ALL OTHER REPADS TO HAVE (1) ø1/4" WEEP HOLE AT LOWEST POINT ON PAD.
4.) MANUFACTURING TOLERANCE TO BE IN ACCORDANCE WITH API STANDARD 650 7.5.
5.) ASME MATERIALS TO CONFORM TO THE FOLLOWING: FLANGES – B16.5, FITTINGS – B16.9 & COUPLINGS – B16.11.
6.) PICKLE ALL EXTERIOR WELDS. PASSIVATE INTERIOR & EXTERIOR OF VESSEL.
7.) GALVANIZING: CAGED LADDER & CROSSOVER PLATFORM TO BE HOT DIPPED GALVANIZED.

NOZZLE SCHEDULE

MARK	SERVICE	SIZE	RATING	TYPE / STYLE	NECK SCHED.	PROJECTION EXT. (℄)	PROJECTION INT. (MIN.)	WELD FIGURE	REPAD SIZE (WIDTH X THK.)	WELD SIZE "A1"	"A2"	"B1"	"B2"	"C1"	"C2"
B	VENT	4"	–	PIPE W/ ELBOWS	40S	SEE DWG	–	4	–	–	–	3/16	1/8	–	–
C	ROOF MANWAY	20"	–	API W/ HINGE	1/4"	SEE DWG	1"	7	–	–	–	3/16	1/8	–	–
D	INLET (LEVEL)	3"	150#	RFSO	40S	SEE DWG	1"	1,7	–	1/8	1/8	3/16	1/8	–	–
E	SHELL MANWAY	24"	–	API W/ DAVIT	1/4"	6"	1"	7	–	–	–	3/16	1/8	–	–
F	OUTLET	4"	150#	RFSO	40S	6"	–	1,4	–	3/16	3/16	1/4	1/8	–	–
G	OUTLET	4"	150#	RFSO	40S	SEE DWG	–	1,4	–	1/4	3/8	1/4	1/8	–	–
K	OUTLET	1"	150#	RFSO	80S	SEE DWG	–	1,4	–	3/16	1/4	3/16	1/8	–	–
L	OUTLET	1"	150#	RFSO W/ BLIND	80S	SEE DWG	–	1,4	–	3/16	1/4	3/16	1/8	–	–
N	HI-HI PROB	1"	3000#	FULL THRD CPLG	–	–	1/2"	7	–	3/16	3/16	3/16	1/8	–	–
P	PROCESS CONN. POINT	3/8"	3000#	HALF THRD CPLG	–	–	–	12	–	–	–	1/4	1/8	–	–
Q	PROCESS CONN. POINT	3/8"	3000#	HALF THRD CPLG	–	–	–	12	–	–	–	1/4	1/8	–	–
R	PROCESS CONN. POINT	3/8"	3000#	HALF THRD CPLG	–	–	–	12	–	–	–	1/4	1/8	–	–
S	PROCESS CONN. POINT	2"	150#	RFSO	80S	SEE DWG	1"	1,7	–	1/4	5/16	1/4	1/8	–	–
T	PROCESS CONN. POINT	2"	150#	RFSO	80S	SEE DWG	1"	1,7	–	1/4	5/16	1/4	1/8	–	–

QUALITY CONTROL

ENG. _____ DATE: _____

Q.C. _____ DATE: _____

This drawing is issued for customer approval. please review, make approval changes (if any) in red. check the appropriate box, sign & date.

- ☐ Approval – no changes. Please proceed with fabrication.
- ☐ Approved as noted. Please proceed with fabrication
- ☐ Not approved. Please make changes and resubmit.

Customer signature _____ Date _____

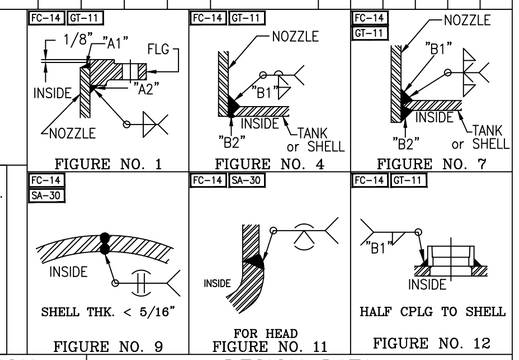

MATERIALS OF CONSTRUCTION

	VESSEL
SHELL	SA240-304/304L
HEADS	SA240-304/304L
RIM ANGLE	SA479-304/304L
NOZZLE NECKS	SA312-304/304L WLD & SA403-304/304L WPW
NOZZLE FLANGES	SA182F-304/304L
MANWAY NECKS	SA240-304/304L
MANWAY FLANGES	SA240-304/304L
GASKETS	GARLOCK 3000
BOLTS/STUDS	SA193-B7 (ZINC PLATED)
NUTS	SA194-2H (ZINC PLATED)
REPADS	SA240-304/304L
COUPLINGS	SA182F-304/304L
SUPPORTS/HOLD DOWNS	SA312-304/304L WLD, SA479-304/304L & SA240-304/304L
LIFTING LUGS	SA240-304/304L
TUBING SUPPORT	1 SA240-304/304L
GROUND LUG	SA240-304/304L
HANDRAIL	SA312-304/304L WLD
HANDRAIL CLIPS	SA479-304/304L
PLATFORM	SA36
PLATFORM CLIPS	SA240-304/304L
JACKET HEADS	–
JACKET NOZZLE NECKS	–
JACKET NOZZLE FLANGES	–

DESIGN DATA

	VESSEL
DESIGN AND FAB. CODE	API 650 AS APPLICABLE
CERT. STAMP REQ'D.	NO
DESIGN PRESSURE	ATM
DESIGN TEMPERATURE	120° F
MIN. DESIGN METAL TEMP.	-20° F @ ATM
OPERATING PRESSURE	–
OPERATING TEMPERATURE	–
JOINT EFFICIENCY HEADS	0.70
JOINT EFFICIENCY SHELL	0.70
CORROSION ALLOWANCE	0"
SPECIFIC GRAVITY	1.0
EARTHQUAKE ZONE	Ss = (0.256) S1 = (0.092)
WIND LOAD	106 MPH
STRESS RELIEF	NOT REQ'D
RADIOGRAPHIC EXAM	NOT REQ'D
DYE PENETRANT EXAM	NOT REQ'D
MAGNETIC PARTICLE EXAM	NOT REQ'D
PNEUMATIC TEST	2 PSIG / GAUGE #1
JKT DESIGN AND FAB. CODE	–
JKT CERT. STAMP REQ'D.	–
JKT DESIGN PRESSURE	–
JKT DESIGN TEMPERATURE	–
JKT MIN. DESIGN METAL TEMP.	–
JKT OPERATING PRESSURE	–
JKT OPERATING TEMPERATURE	–
JKT JOINT EFFICIENCY HEADS	–
JKT JOINT EFFICIENCY SHELL	–

VESSEL FINISH

INTERIOR WELD TREATMENT:	SAV TANK STANDARD
EXTERIOR WELD TREATMENT:	SAV TANK STANDARD
SAV TANK FINISHING STANDARD:	SEE NOTE 6
INSULATION:	N/A
GALVANIZING:	SEE NOTE 7

VESSEL CAPACITY AND WEIGHTS

OPERATING CAPACITY	–
FULL CAPACITY	54,000 GAL.
EMPTY SHIPPING WEIGHT W/O ACCESSORIES	26,800 LBS.
WEIGHT FULL OF WATER	478,500 LBS.
WEIGHT FULL OF PRODUCT	478,500 LBS.
WEIGHT OF ACCESSORIES	900 LBS.

REVISIONS

REV	D.BY	C.BY	DATE	DESCRIPTION
2				AS BUILT
1	RS	AD	5/13/24	CERTIFIED
0	RS	AD	3/26/24	APPROVAL

Savannah Tank & Equipment Corp.
1517 Telfair Road, Savannah, GA 31415
(912) 233-8902

DRAWN BY: RS
CHK'D BY: AD
APPROVED BY: NP
SCALE: 3/16" = 1'-0"

PERDUE
RBD OIL TANK #2
EQUIP. #
CUST. PO # 3002519BOR

DRAWING NO.: 018-24-1 SHT 1 OF 7 REV. SET 1