LONG SEAMS	
COURSE	ORIENTATION
1	90°

Ship loose items:
None

NOTE 6: PICKLE ALL EXTERIOR WELDS. INTERIOR TO BE #4 POLISH & PASSIVATE INTERIOR & EXTERIOR OF VESSEL.

NOTE 7: INTERIOR WELDS TO BE GROUND SMOOTH NOT FLUSH.

***NOTE: ALL ELEVATIONS ARE PULLED FROM WELD SEAM FOR EASE OF FABRICATION**

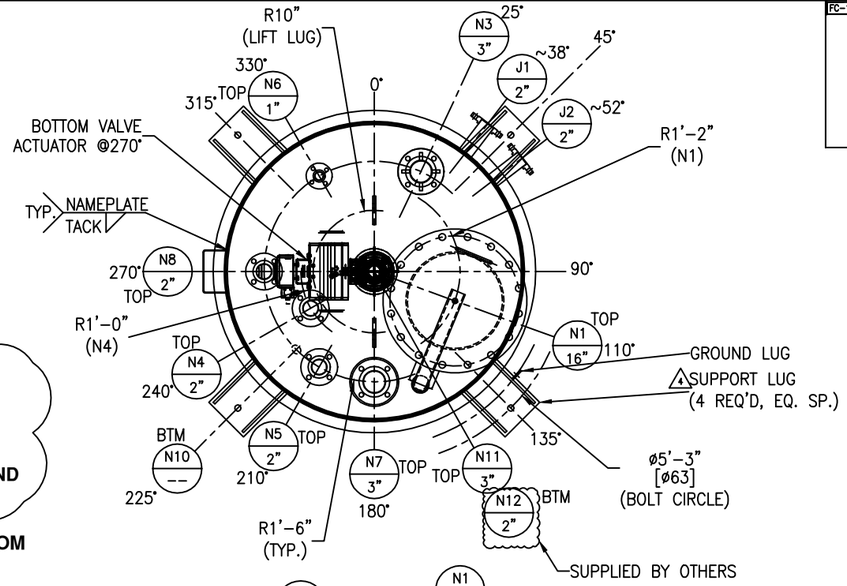

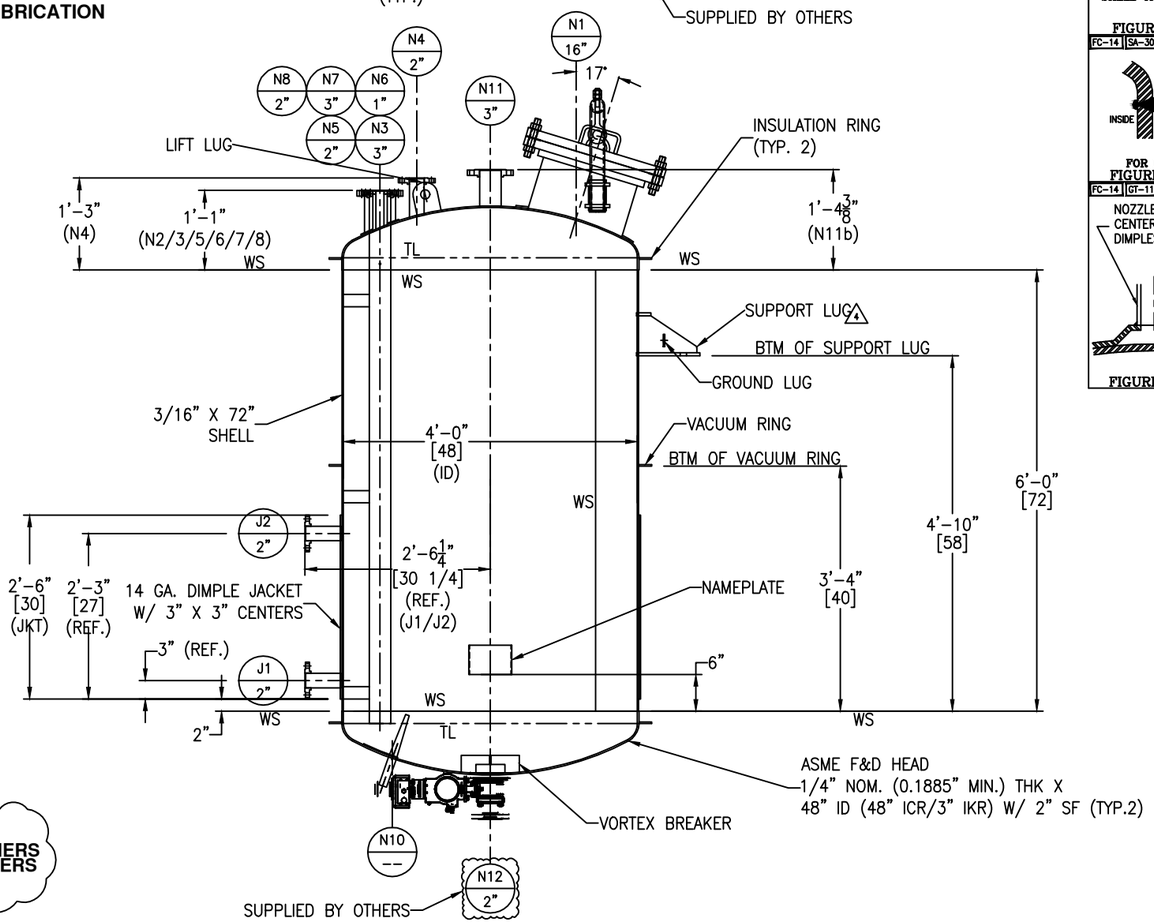

SPRAYBALL SUPPLIED BY OTHERS
FLUSH OUTLET VALVE BY OTHERS

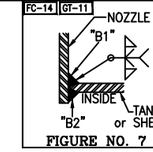

FIGURE NO. 7

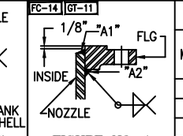

FIGURE NO. 1

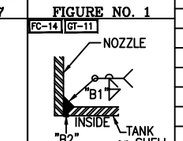

FIGURE NO. 4

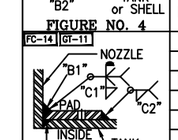

FIGURE NO. 5

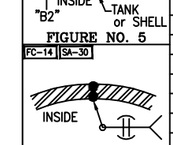

FIGURE NO. 9

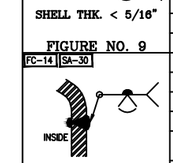

FOR HEADS
FIGURE NO. 11

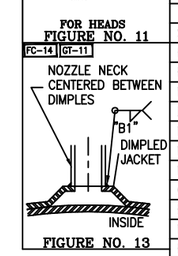

FIGURE NO. 13

NOZZLE SCHEDULE

MARK	SERVICE	SIZE	RATING	TYPE / STYLE	NECK SCHED.	PROJECTION EXT. (E)	PROJECTION INT. (MIN.)	WELD FIGURE	REPAD SIZE (WIDTH X THK.)	WELD SIZE "A1"	WELD SIZE "A2"	WELD SIZE "B1"	WELD SIZE "B2"	WELD SIZE "C1"	WELD SIZE "C2"
N1	MANWAY	16"	150#	RFSO W/DAVIT	1/4"	SEE DWG	–	1,5	2" X 1/4"	1/4	3/8	1/4	1/8	1/4	3/16
–	–	–	–	–	–	–	–	–	–	–	–	–	–	–	–
N3	VENT	3"	150#	RFSO	40S	SEE DWG	–	1,5	4 2" X 1/4"	1/4	5/16	1/4	1/8	1/4	3/16
N4	LEVEL TRANSMITTER	2"	150#	RFSO	40S	SEE DWG	–	1,4	–	3/16	1/4	3/16	1/8	–	–
N5	LEVEL SWITCH	2"	150#	RFSO	40S	SEE DWG	–	1,4	–	3/16	1/4	3/16	1/8	–	–
N6	NITROGEN	1"	150#	RFSO	40S	SEE DWG	–	1,4	–	3/16	3/16	3/16	1/8	–	–
N7	FILL/RECIRCULATION	3"	150#	RFSO	40S	SEE DWG	–	1,7	–	1/4	5/16	3/16	1/8	–	–
N8	PRESSURE	2"	150#	RFSO	40S	SEE DWG	–	1,4	–	3/16	1/4	3/16	1/8	–	–
N9	–	–	–	–	–	–	–	–	–	–	–	–	–	–	–
N10	THERMOWELL	–	–	WIL12316P1T THERMOWELL	–	SEE DWG	–	7	–	–	–	3/16	1/8	–	–
–	4 –	–	–	–	–	–	–	–	–	–	–	–	–	–	–
N11	SPRAYBALL BASE	3"	150#	RFSO W/BLIND	40S	SEE DWG	–	1,4	–	1/4	5/16	1/4	1/8	–	–
N12	BOTTOM OUTLET	2"	--	FLUSH OUTLET VALVE	–	–	–	4	–	–	–	1/4	1/8	–	–
J1	JACKET INLET	2"	150#	RFSO	40S	5 3/4"	–	13	–	3/16	1/4	3/16	–	–	–
J2	JACKET OUTLET	2"	150#	RFSO	40S	5 3/4"	–	13	–	3/16	1/4	3/16	–	–	–

MATERIALS OF CONSTRUCTION

	VESSEL
SHELL	SA240-316/316L (#4 POLISH INSIDE)
HEADS	SA240-316/316L (#4 POLISH INSIDE)
RIM ANGLE	–
NOZZLE NECKS	SA312-316/316L WLD (#4 POLISH INSIDE)
DIP-TUBES	SA312-316/316L WLD (#4 POLISH BOTH SIDES)
NOZZLE FLANGES	SA182F-316/316L
MANWAY NECKS	SA240-316/316L (#4 POLISH INSIDE)
MANWAY FLANGES	SA182F-316/316L
GASKETS	PTFE
BOLTS/STUDS	SA193-B7 (ZINC PLATED)
NUTS	SA194-2H (ZINC PLATED)
REPADS	SA240-304/304l
COUPLINGS/PLUG	SA182F-316/316L
STUDPAD	SA182F-316/316L
SUPPORTS/HOLD DOWNS	SA240-304/304L
LIFTING LUGS	SA240-304/304L
VACUUM RINGS	SA240-304/304L
INSULATION RINGS	SA240-304/304L
GROUND LUG	SA240-304/304L
WEAR PLATE	SA240-316/316L (#4 POLISH ONE SIDE)
VORTEX BREAKER	SA240-316/316L (#4 POLISH BOTH SIDE)
HANDRAIL	–
PLATFORM	–
PLATFORM CLIPS	–
DIPTUBE SUPPORT	SA240-316/316L (#4 POLISH BOTH SIDE)
JACKET SHELL	SA240-304/304L
JACKET HEADS	–
JACKET NOZZLE NECKS	SA312-304/304L WLD
JACKET NOZZLE FLANGES	SA182F-304/304L

DESIGN DATA

	VESSEL
DESIGN AND FAB. CODE	ASME
CERT. STAMP REQ'D.	YES
DESIGN PRESSURE	50 PSIG/ FV
DESIGN TEMPERATURE	600° F
MIN. DESIGN METAL TEMP.	-20° F @ 50 PSIG
OPERATING PRESSURE	5 PSIG
OPERATING TEMPERATURE	176° F
JOINT EFFICIENCY HEADS	0.70
JOINT EFFICIENCY SHELL	0.70
CORROSION ALLOWANCE	0"
SPECIFIC GRAVITY	0.90
EARTHQUAKE ZONE	Ss = (0.550) S1 = (0.160)
WIND LOAD	INDOOR
STRESS RELIEF	NOT REQ'D
RADIOGRAPHIC EXAM	NOT REQ'D
DYE PENETRANT EXAM	NOT REQ'D
MAGNETIC PARTICLE EXAM	NOT REQ'D
HYDROSTATIC TEST	77 PSIG
PNEUMATIC TEST	–
JKT DESIGN AND FAB. CODE	ASME
JKT CERT. STAMP REQ'D.	YES
JKT DESIGN PRESSURE	95 PSIG
JKT DESIGN TEMPERATURE	600° F
JKT MIN. DESIGN METAL TEMP.	-20° F @ 95 PSIG
JKT OPERATING PRESSURE	50 PSIG
JKT OPERATING TEMPERATURE	572° F
JKT JOINT EFFICIENCY HEADS	–
JKT JOINT EFFICIENCY SHELL	0.70
JKT HYDRO TEST	124 PSIG

VESSEL FINISH

INTERIOR WELD TREATMENT:	SEE NOTE 7
EXTERIOR WELD TREATMENT:	SAV TANK STANDARD
SAV TANK FINISHING STANDARD:	SEE NOTE 6
INSULATION:	2" BY OTHERS
PAINTING:	N/A

VESSEL CAPACITY AND WEIGHTS

OPERATING CAPACITY	420 GAL.
FULL CAPACITY	650 GAL.
EMPTY SHIPPING WEIGHT	2,000 LBS.
WEIGHT FULL OF WATER	7,650 LBS.
WEIGHT FULL OF PRODUCT	7,100 LBS.

ASME SECT. VIII, DIV. 1
2023 EDITION

ENG. _____ DATE: _____
Q.C. _____ DATE: _____
A.I. _____ DATE: _____

This drawing is issued for customer approval. please review, make approval changes (if any) in red. check the appropriate box, sign & date.

- ☐ Approval – no changes. Please proceed with fabrication.
- ☐ Approved as noted. Please proceed with fabrication
- ☐ Not approved. Please make changes and resubmit.

Customer signature _____ Date _____

GENERAL NOTES

1.) COVER ALL FLANGES, OPENINGS & MACHINED SURFACES PRIOR TO SHIPMENT UNLESS OTHERWISE NOTED.
2.) BOLT HOLES TO STRADDLE 0° & 180° UNLESS OTHERWISE NOTED.
3.) REPADS TO HAVE (1) ø1/4" NPT TELL-TALE HOLES FOR PNEUMATIC TESTING AT 2 PSIG FOR PRESSURE RETAINING PARTS. ALL OTHER REPADS TO HAVE (1) ø1/4" WEEP HOLE AT LOWEST POINT ON PAD.
4.) ASME CODE VESSELS TO BE IN ACCORDANCE WITH UG-80 & UG-81. TOLERANCES: +/- 1/8" FOR DIMENSIONS, AND +/- 2 DEGREES FOR ORIENTATIONS.
5.) ASME MATERIALS TO CONFORM TO THE FOLLOWING: FLANGES – B16.5, FITTINGS – B16.9 & COUPLINGS – B16.11.
6.) PICKLE ALL EXTERIOR WELDS. INTERIOR TO BE #4 POLISH & PASSIVATE INTERIOR & EXTERIOR OF VESSEL. 3
7.) INTERIOR WELDS TO BE GROUND SMOOTH NOT FLUSH.

REVISIONS

REV	D.BY	C.BY	DATE	DESCRIPTION
				AS BUILT
4	RS	NP	2/24/26	CERTIFIED REV 3
3	RS	NP	1/30/26	CERTIFIED REV 2
2	RS	NP	1/15/26	CERTIFIED REV 1
1	AD	RS	12/17/25	CERTIFIED
0	AD	RS	11/25/25	APPROVAL

Savannah Tank & Equipment Corp.
1517 Telfair Road, Savannah, GA 31415
(912) 233-8902

DRAWN BY: AD
CHK'D BY: RS
APPROVED BY: NP
SCALE: 3/4" = 1'-0"

EPIC SYSTEMS GROUP, LLC.
SHELL B SURGE TANK
EQUIP. #T-118B
CUST. PO #64350

DRAWING NO.: 112-25-1 SHT 1 OF 4 REV. SET 4